

TO 1/4 COR.


1318.52'

N 0° 57' 48" E

2060.75'

716.82'

25.41'

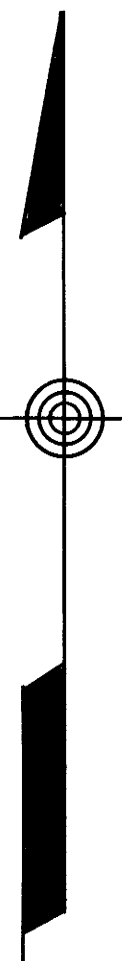

LEASE - OPTION
30.05 ACRES

656.45'

1312.90'

N 89° 47' 30" E

656.45'

ARTESANI
PURCHASE
28.13 ACRES

1318.96'

N 1° 03' 36" E

1927.13'

608.17'

N 89° 45' 25" E

658.70'

1317.40'

658.70'

N 1° 09' 26" E

1793.61'

474.20'

N 1° 09' 26" E

845.21'

TO SW COR. SEC. 22

BASIS OF BEARING
THE BEARING OF THE HIGHWAY 395 TANGENT OF S 78° 42' 30" E ALONG
THE SOUTHERLY SIDE OF THIS PROPERTY IS THE BASIS OF BEARINGS OF
THIS SURVEY.

PLANNING COMMISSION'S CERTIFICATE
THIS IS TO CERTIFY THAT THIS PARCEL MAP IS IN ACCORD WITH
THE ~~PLANNING~~ ~~COMMISSION'S~~ ~~CERTIFICATE~~ ~~APPROVED~~ ~~MAP OF THE PARCELS~~
APPROVED BY MONO COUNTY PLANNING COMMISSION

604 BY

[Signature]

RECORDER'S CERTIFICATE

FILED FOR RECORD THIS 24th DAY OF Sept, 1969, AT
3:00 P.M., IN BOOK 6 OF maps ON PAGE 158, AT THE REQUEST
OF Arthur

[Signature]
COUNTY RECORDER

COUNTY SURVEYOR'S CERTIFICATE
THIS MAP HAS BEEN EXAMINED FOR CONFORMANCE WITH THE
REQUIREMENTS OF THE LAND SURVEYOR'S ACT THIS DAY OF
 1969.

COUNTY SURVEYOR

SURVEYOR'S CERTIFICATE
THIS MAP CORRECTLY REPRESENTS A SURVEY MADE BY ME IN
CONFORMANCE WITH THE REQUIREMENTS OF THE LAND SURVEYOR'S
ACT ON MAY 28, 1969, AT THE REQUEST OF E.J. ARTESANI.

[Signature]
WALTER G. REID R.C.E. 7522
VIRGINIA CITY, NEVADA

MONO COUNTY, CALIFORNIA

RECORD OF SURVEY MAP OF
THE ARTESANI PARCELS
A PORTION OF W 1/2 W 1/2
AND E 1/2 W 1/2 SEC. 22
T. 6N., R. 24E., M. DBAM.

SCALE - 1" = 100'

0 25 50 100 200 300 400
WALTER G. REID R.C.E. 7522 VIRGINIA CITY, NEV.

PM 4-03-69

2nd 6 pg. 58